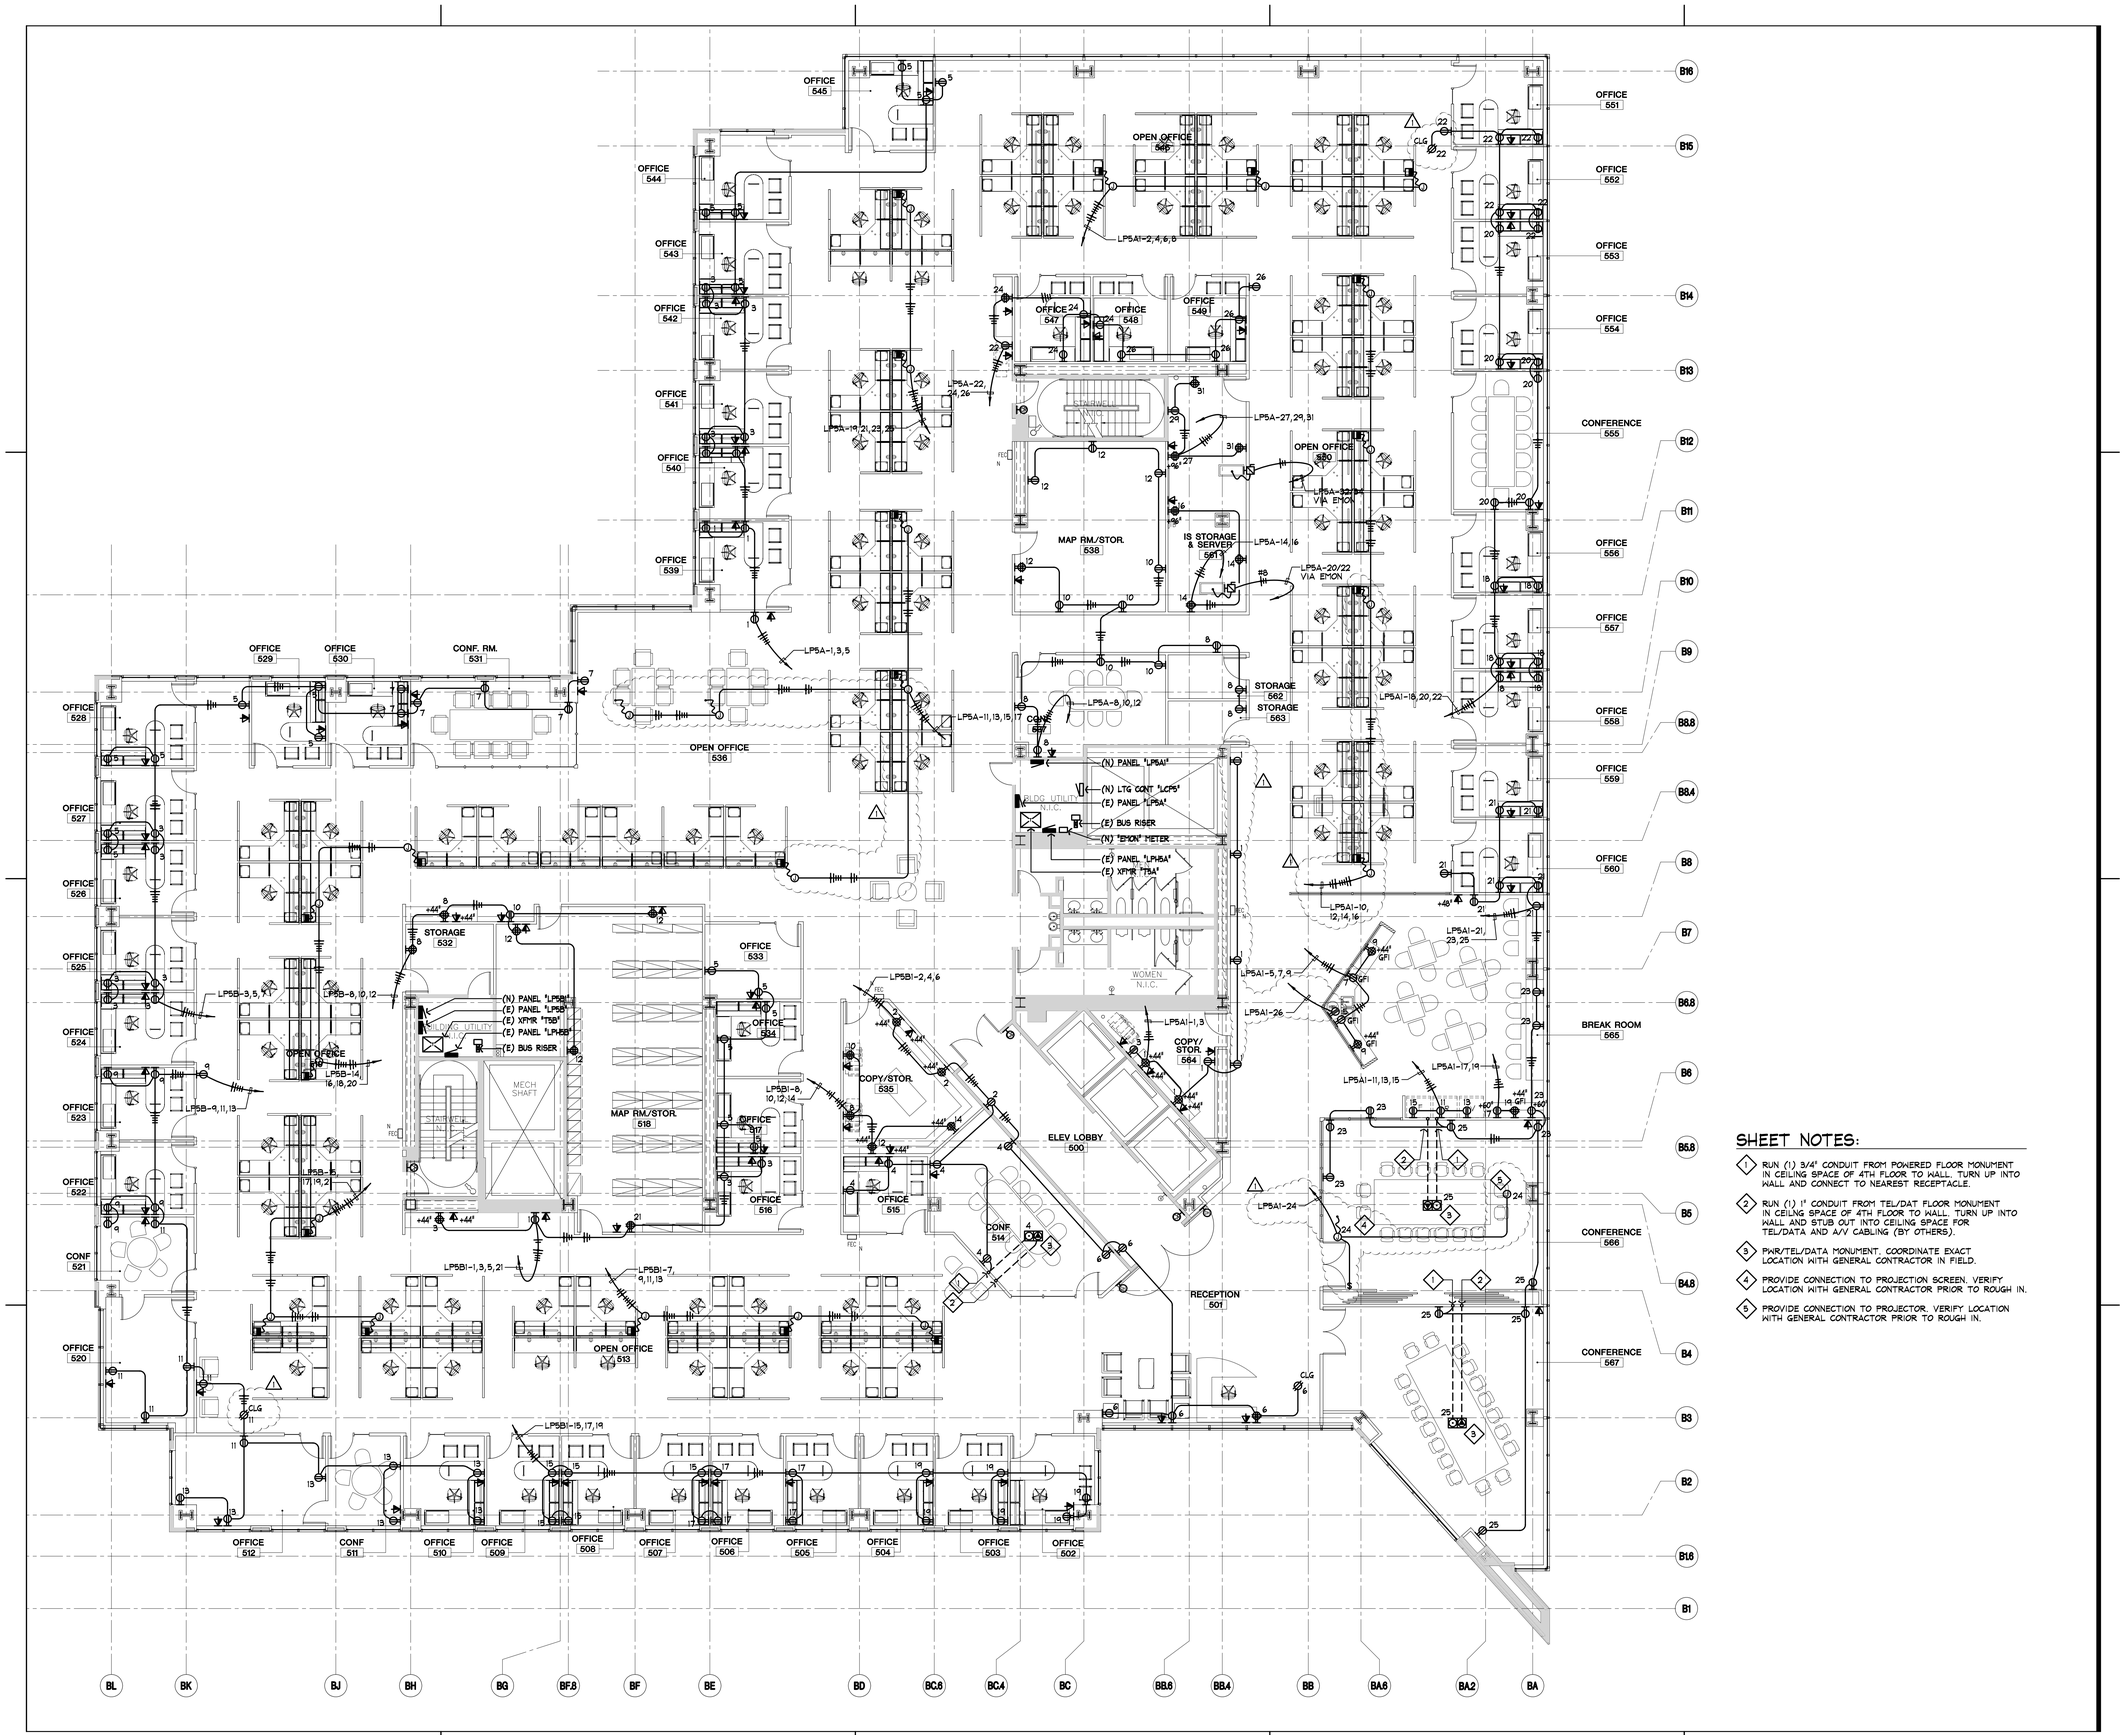

SHEET NOTES:

1. RUN (1) 3/4" CONDUIT FROM POWERED FLOOR MONUMENT IN CEILING SPACE OF 4TH FLOOR TO WALL. TURN UP INTO WALL AND CONNECT TO NEAREST RECEPTACLE.
2. RUN (1) 1" CONDUIT FROM TEL/DAT FLOOR MONUMENT IN CEILNG SPACE OF 4TH FLOOR TO WALL. TURN UP INTO WALL AND STUB OUT INTO CEILING SPACE FOR TEL/DATA AND A/V CABLING (BY OTHERS).
3. PWR/TEL/DATA MONUMENT. COORDINATE EXACT LOCATION WITH GENERAL CONTRACTOR IN FIELD.
4. PROVIDE CONNECTION TO PROJECTION SCREEN. VERIFY LOCATION WITH GENERAL CONTRACTOR PRIOR TO ROUGH IN.
5. PROVIDE CONNECTION TO PROJECTOR. VERIFY LOCATION WITH GENERAL CONTRACTOR PRIOR TO ROUGH IN.

Pulte Homes

6210 Stoneridge Mall Road
5th Floor
Pleasanton, CA.

CEI

CANSINO ELECTRIC INC. DESIGN / BUILD
1063-B SERPENTINE LN.,
PLEASANTON, CA 94566
(925) 485-5959 Fax (925) 485-5955
Lic. #670064

THE WITHIN DESIGN IS THE SOLE AND EXCLUSIVE PROPERTY OF CANSINO ELECTRIC, INC. AND IS NOT TO BE USED, COPIED, OR REPRODUCED, IN WHOLE OR IN PART BY ANY OTHER PERSON. EXHIBITION HEREOF IS SOLELY FOR THE PURPOSE OF EFFECTING A SALE OF THE DELINEATED ELECTRICAL DESIGN OR INSTALLATION TO CUSTOMERS OR PROSPECTIVE CUSTOMERS OF CANSINO ELECTRIC, INC.

Revision	Date	Description	By
2	04/19/04	ISSUED FOR PERMIT	CEI
1	05.13.04	PLAN CHECK & TENANT REVISIONS	CEI

LICENSED ELECTRICAL CONTRACTOR CANSINO ELECTRIC, INC. LICENSE NO. 670064 STATE OF CALIFORNIA

Project No. :	Scale :	
04-038	1/8"=1'-0"	
Date :	Drawn By :	Checked By :
04/19/04	BCE	CEI

Sheet Title :

5TH FLOOR POWER PLAN

SHEET NUMBER

TE-5.5